


## SECTION A-A

## SECTION B-B

WELDING AT SHOP DURING ASSEMBLY

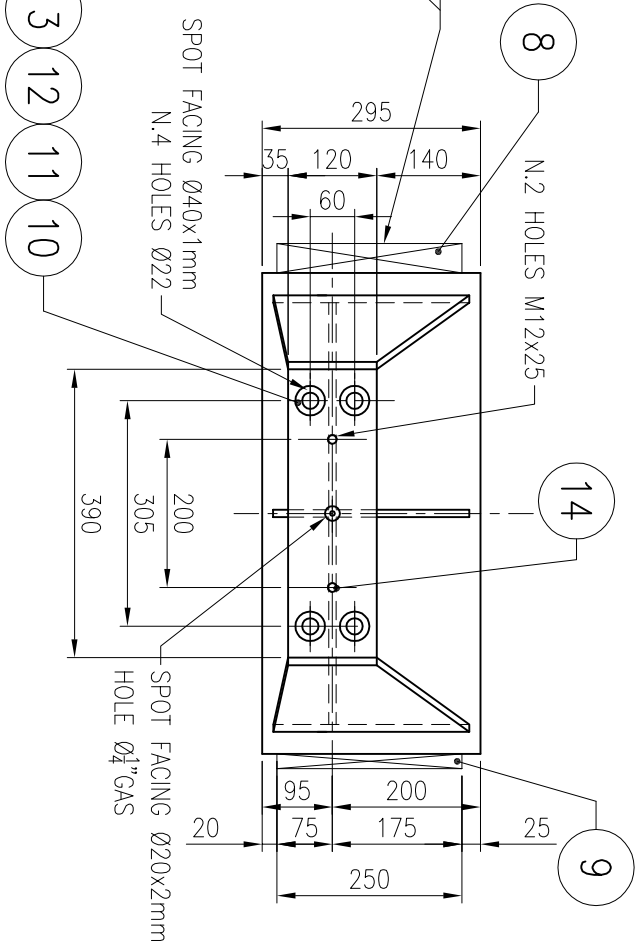

FOR N.1 CRANE MANUFACTURE N.2 PIECES

$$\frac{25}{\Delta} \left( \frac{6.3}{\Delta} \frac{3.2}{\Delta} \frac{1.6}{\Delta} \right)$$
[illegible]