


SECTION A-A

(*) Material : S355J0 or Equivalent

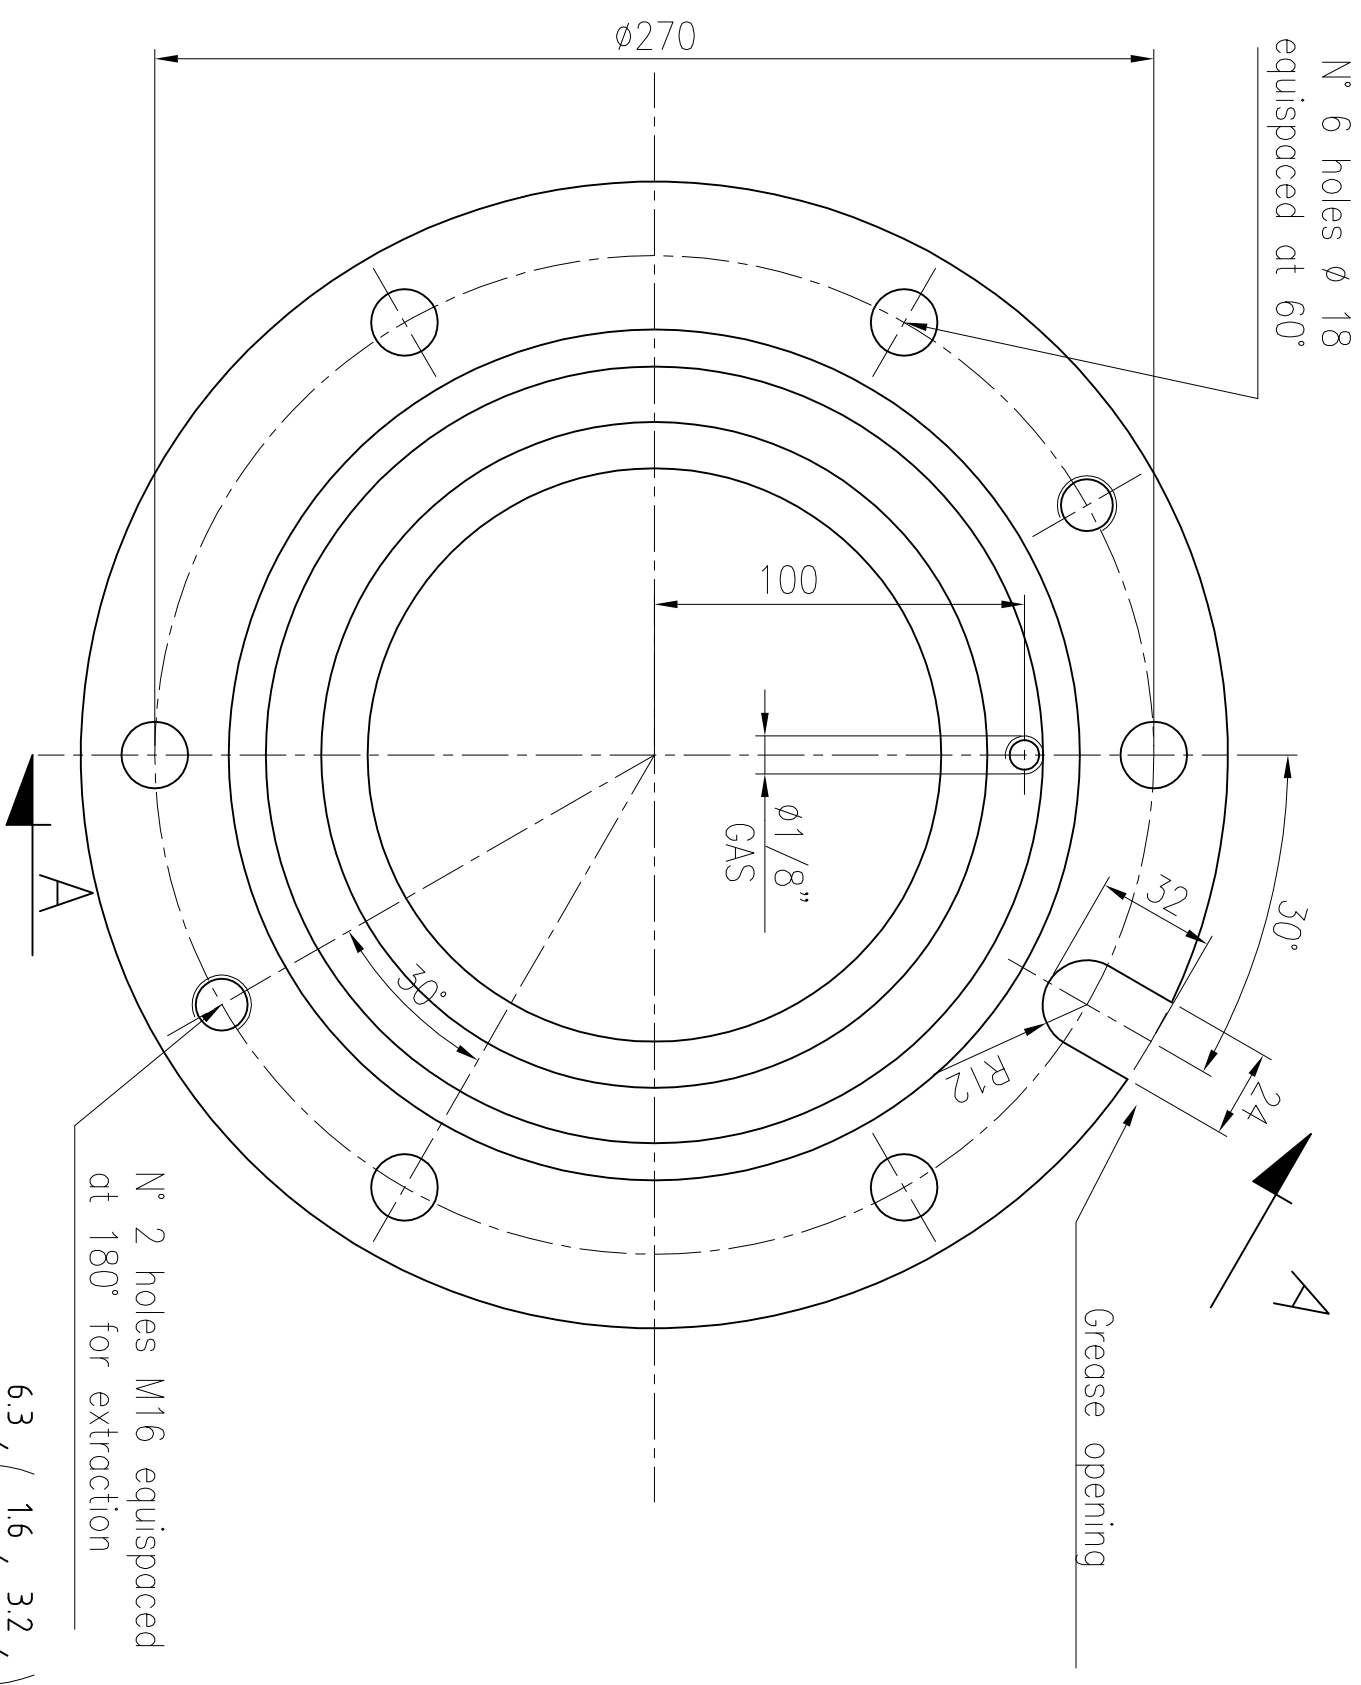

FOR N.1 CRANE MANUFACTURE N.4 PIECES

6.3 1.6 3.2

DATA	MODIFICA ESEGUITA O MOTIVO DELLA SOSTITUZ.						DIS.	APP.
DATE	MODIFICATION EXECUTED OR REASON OF THE REPLACEMENT						DRAWER	
Fabb. di riferimento N. Ref. material list	Materiale Material	Treatment	Toll. gen. lov. Mach tolerance	Mod. o stampo Type	Peso Weight	Scala Scale		
12834-5600/5610	(*)		H11-d11		5	1:2		

MGM

OMG

ROKAS
CONSTRUCTIONS
TEL. +30-2108774100
FAX +30-2108774121 or 111
WWW.ROKASGR

Customer: PIRAEUS PORT AUTHORITY
Object: N.8 RMG 40t
Project: F0010

DIS. DRAWER	<i>GN</i>	
VER.	DB	DATA DATE
APP.	RM	08/10/08

OPEN COVER

Comm. / Job

N. 18033

N. 12834-5605

$$\frac{1}{1}$$

Formato: A3

→

2

3

Formato: A3
