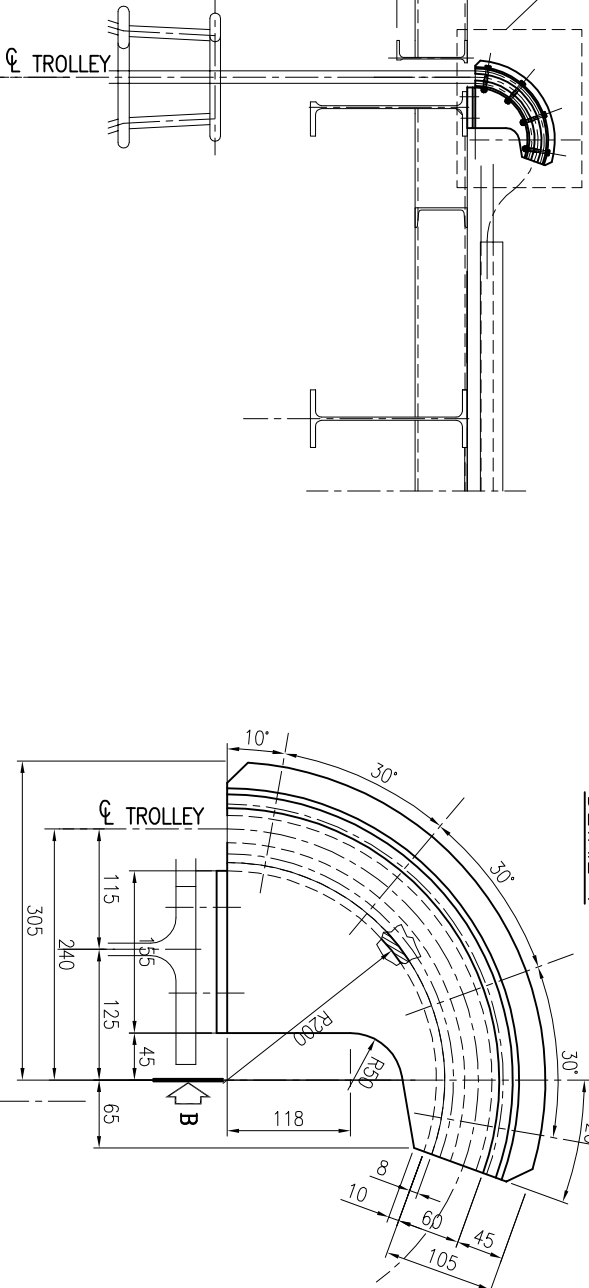
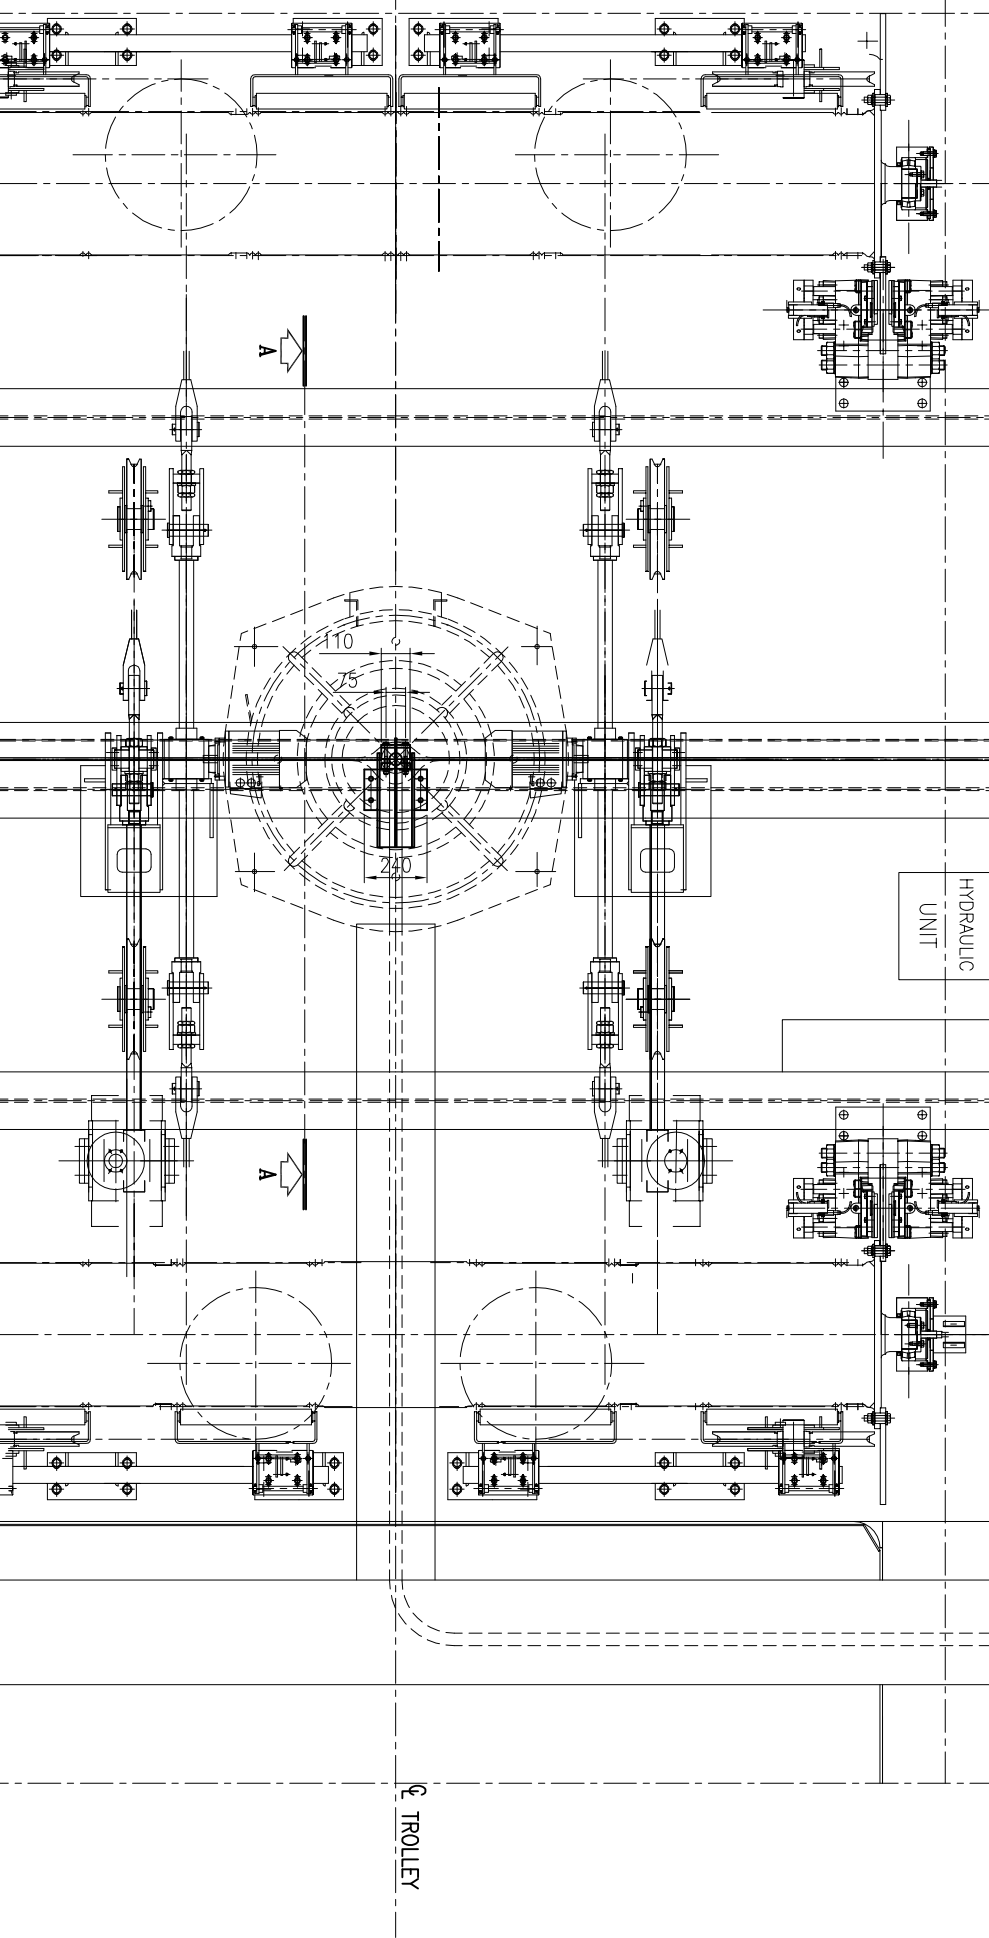


Technical drawing showing a cross-section of a wall and window frame. The drawing includes a dimension line indicating a width of 270. A detail callout labeled "DETAIL 1" points to a curved section of the wall, which is shown in a separate view with a dashed line indicating the location of the detail.

[illegible][illegible]