



1

2

3

4

SECTION A-A

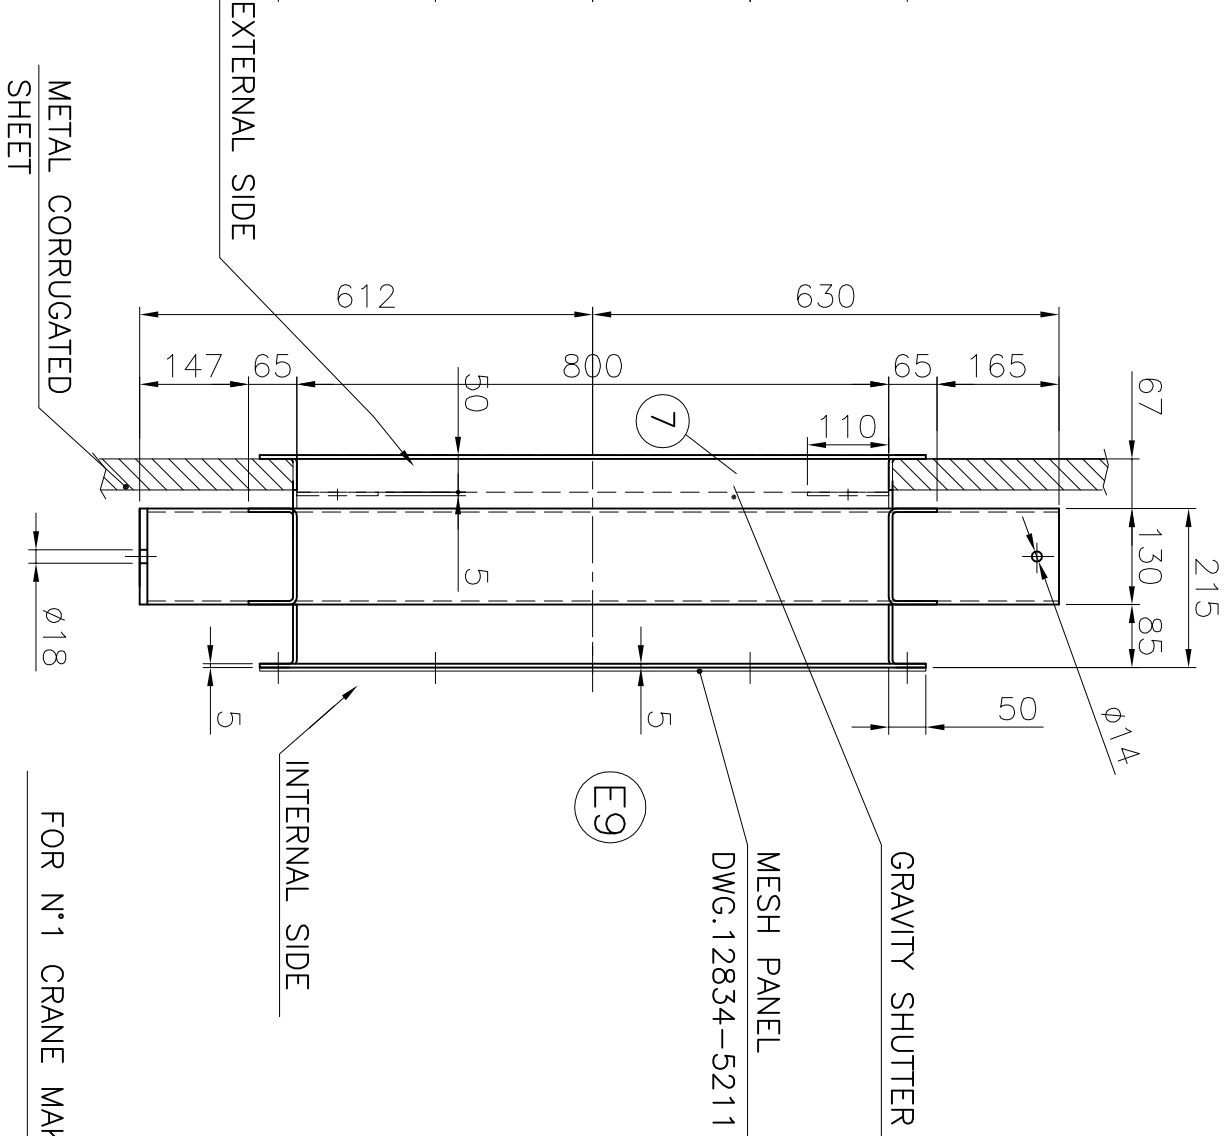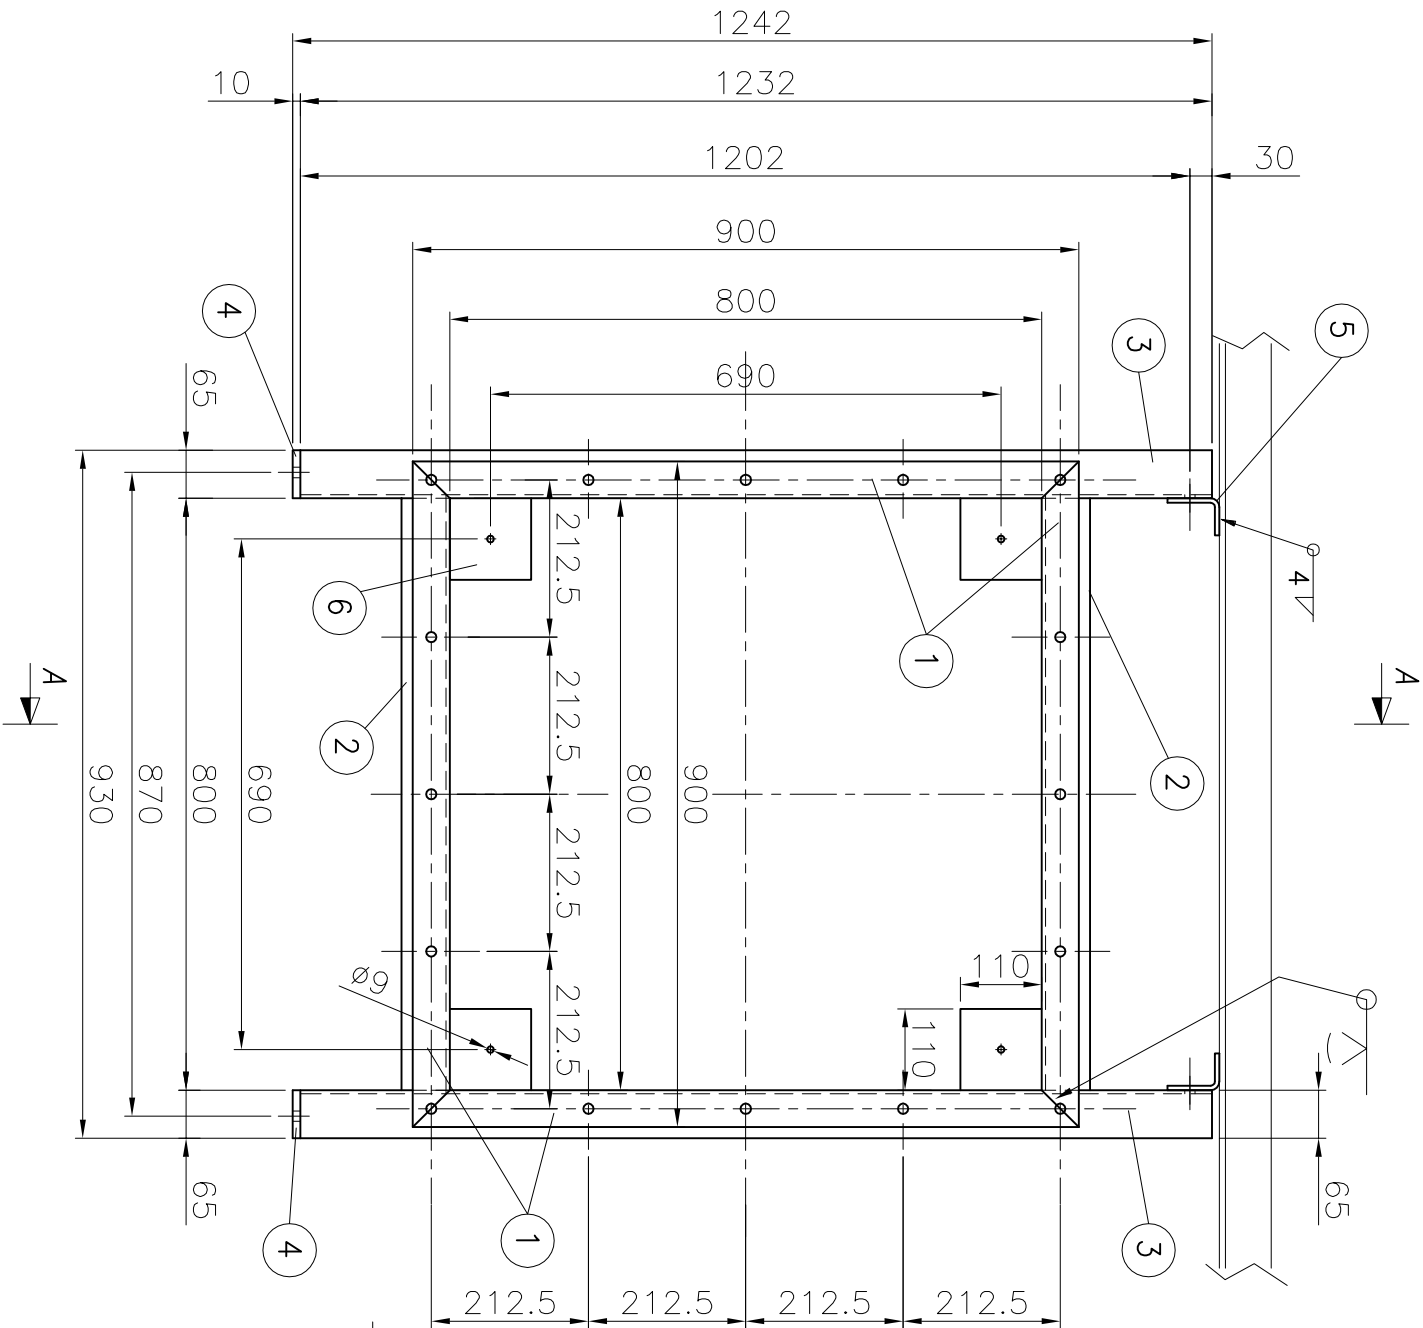

NOTE

EXCEPT WHERE OTHERWISE INDICATED WELDS MUST BE $\alpha \geq 0.7 \times \text{MIN. THK}$

01	06/03/09	GENERAL REVISION						TM	RM
00	11/02/09	FIRST ISSUE						TM	RM
	DATA DATE	MODIFICA ESEGUITA O MOTIVO DELLA SOSTITUZ. MODIFICATION EXECUTED OR REASON OF THE REPLACEMENT						DIS. DRAWER	APP.
	Fabb. di riferimento N. Ref. material list 12834-5207	Materiale Material See material list	Treatmento Treatment	Toll. gen. lov. Mach tolerance	Mod. o stampo Type	Peso Weight Kg	79		Scale Scale 1:10

MGM

ROKAS

Customer: PIRAEUS PORT AUTHORITY

DIS.
DRAWER

TM

DATA DATE

OMG

CONSTRUCTIONS S.A.

Object: N.8 RMG 40t

VER.

DB

APP.

RM

11/02/09

PIRAEUS PORT AUTHORITY

Dis. di riferimento N.
Ref. Drawing

12834-5200

Pos.

7

00

N.8 RMG 40t SPAN 42500

Comm. / Job

Disegno / Drawing

1/1

01

GRAVITY SHUTTER FRAME

N. 18033

N. 12834-5207

1

2

3

Formato: A3