

(*) Material : S235JR or Equivalent

FOR N.1 CRANE MANUFACTURE N.24 PIECES

00	14/02/09	FIRST ISSUE				GF		RM
	DATA		MODIFICA ESEGUITA O MOTIVO DELLA SOSTITUZ.				DIS.	APP.
	DATE		MODIFICATION EXECUTED OR REASON OF THE REPLACEMENT				DRAWER	
Fabb. di riferimento N. Ref. material list		Materiale Material	Treatment Treatment	Toll. gen. lav. Mach tolerance	Mod. o sfompo Type	Peso Weight		Scala Scale
12834-5501/5520		(*)		H11-d11		0.5		1:1

MGM

ROKAS

Customer: **PIRAEUS PORT AUTHORITY**

CONSTRUCTIONS S.A.

TEL. +30-2108774100
FAX +30-2108774121 or 111
WWW.ROKASGROUP.GR

Project: F0010

<i>GF</i>	
DIS. DRAWER	
VER.	DB DATA DATE
APP.	RM 14/02/09

Dis. di riferimento N.
Ref. Drawing
12834-5501/5520

Pos.	15
------	----

	00
--	----

KEY PLATE FIXING ROPE D.20



Comm. / Job

N. 18033

N. 12834-5502

—

Formato: A4

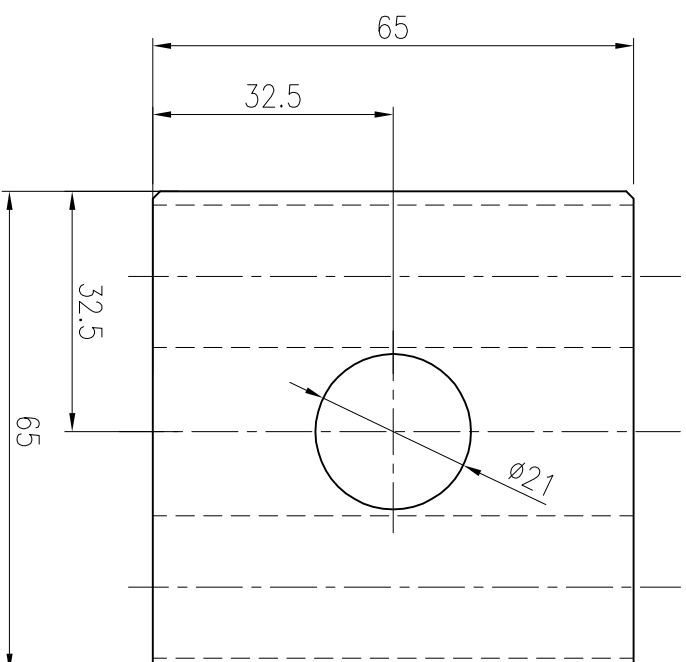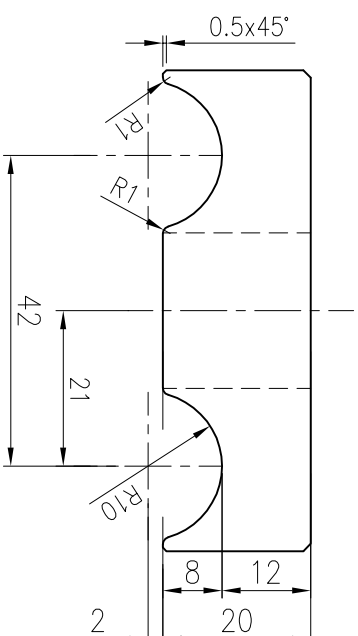

(*) Material : S235JR or Equivalent

FOR N.1 CRANE MANUFACTURE N.24 PIECES

00	14/02/09	FIRST ISSUE				GF		RM
	DATA		MODIFICA ESEGUITA O MOTIVO DELLA SOSTITUZ.				DIS.	APP.
	DATE		MODIFICATION EXECUTED OR REASON OF THE REPLACEMENT				DRAWER	
Fabb. di riferimento N. Ref. material list		Materiale Material	Treatment Treatment	Toll. gen. lav. Mach tolerance	Mod. o sfompo Type	Peso Weight		Scala Scale
12834-5501/5520		(*)		H11-d11		0.5		1:1

MGM

ROKAS

Customer: **PIRAEUS PORT AUTHORITY**

CONSTRUCTIONS S.A.

TEL. +30-2108774100
FAX +30-2108774121 or 111
WWW.ROKASGROUP.GR

Project: F0010

<i>GF</i>	
DIS. DRAWER	
VER.	DB DATA DATE
APP.	RM 14/02/09

Dis. di riferimento N.
Ref. Drawing
12834-5501/5520

Pos.	15
------	----

	00
--	----

KEY PLATE FIXING ROPE D.20

Comm. / Job

N. 18033

N. 12834-5502

—

Formato: A4