


POSITION 1

N.1 Piece

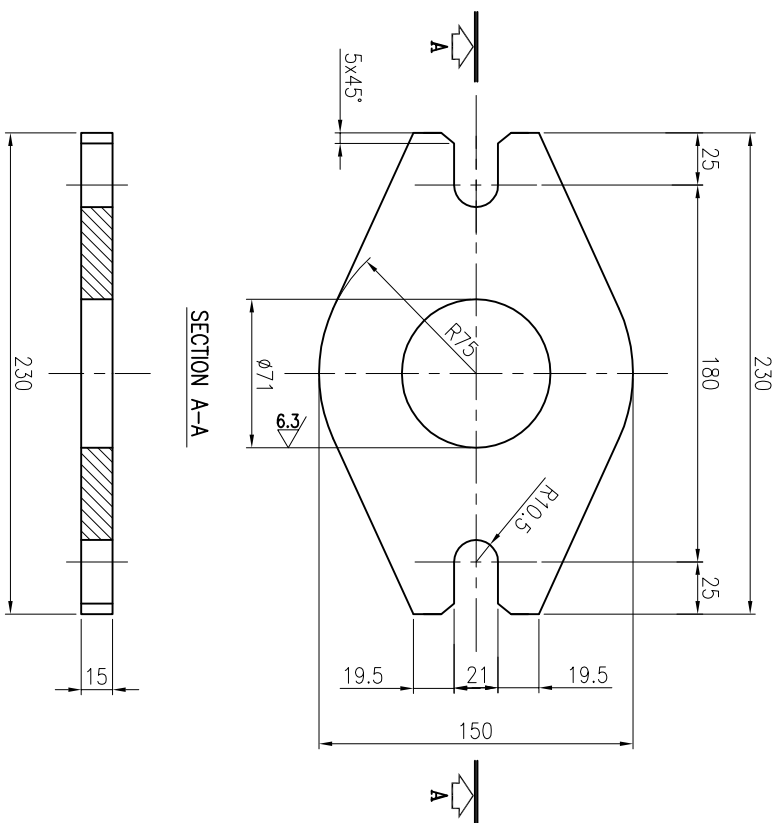


2,5 kg.

S355J0 or equivalent

POSITION 2

N.1 Piece

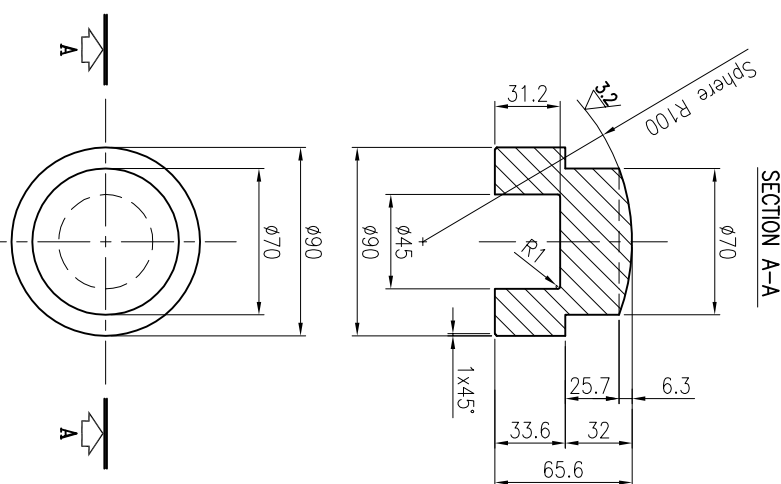


2.5 kg.

C45 or equivalent

POSITION 4

N.1 Piece

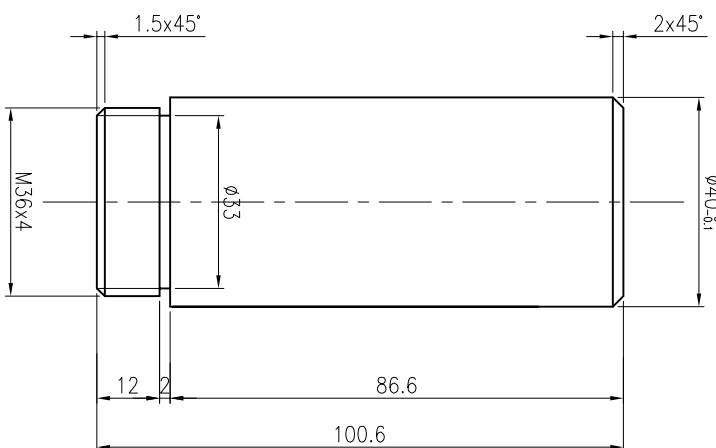

POSITION 6

1 kg

S355J0 or equivalent

MANUFACTURE:
N.2 Piece Thk.5
S355J0 or equi

N.4 Piece Thk.3

\$355.10 or equivalent

0.5 kg



POSITION 7

MANUFACTURE:
N.8 Piece Thk.

\$355J0 or equivalent

1 kg

01	14/04/09	REVSD POS. 1, 2	LD	RM
00	01/04/09	FIRST ISSUE	LS	RM
	DATA DATE	MODIFICA ESEGUITA O MOTIVO DELLA SOSTITUZ. MODIFICATION EXECUTED OR REASON OF THE REPLACEMENT	DIS- DRAWER	APP- DRAWER

Fabb. di riferimento N. Ref. materiali list 12834-5540	Materiale Material SEE M.L.	Trattamento Treatment -	Toll. gen. lav. Mach toleran H11-d11	Mod. a stampo Mach type -	Peso Kg Weight 20	Scala Scale 1:2.5
<div> <div>   </div> <div> ROKAS CONSTRUCTIONS S.A. Project: F0010 </div> <div> Customer: PIRAEUS PORT AUTHORITY Object: N.8 RM6 40t Project: F0010 </div> <div> DIS. BROKER YER. APP. </div> <div> DATA DATE 01/04/09 </div> </div>						
TEL. +36-1087974100 FAX. +36-1087971024111 WWW.ROKASCONSTRUCTION.COM						

FOR N.1 CRANE MANUFACTURE N.2 SET THIS DWG.


C45 or equivalent

2.5 kg.


 $\triangle 6.3$

POSITION 3

N.1 Piece

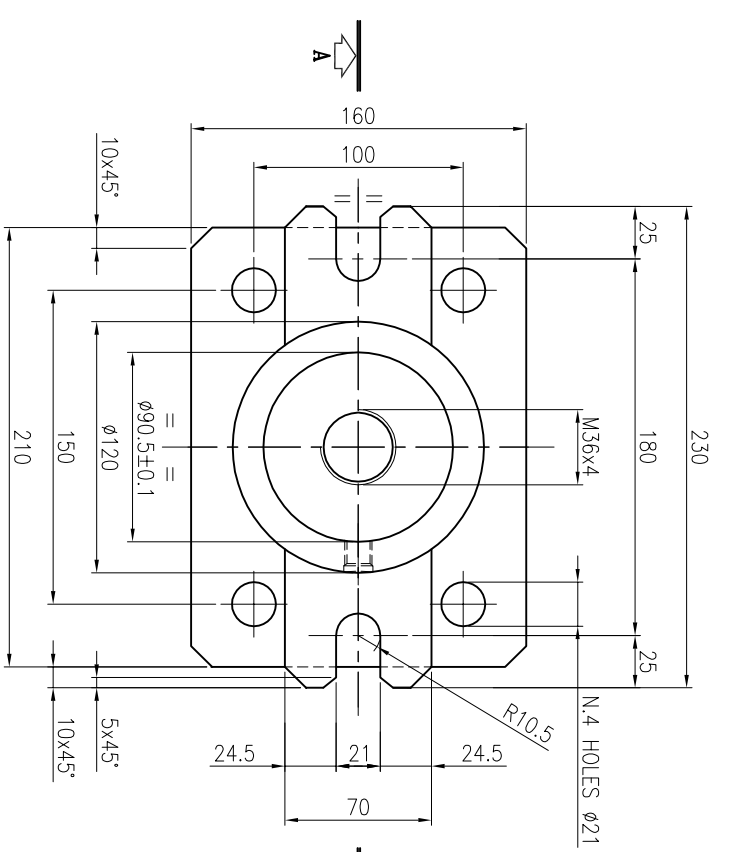

SECTION A-A

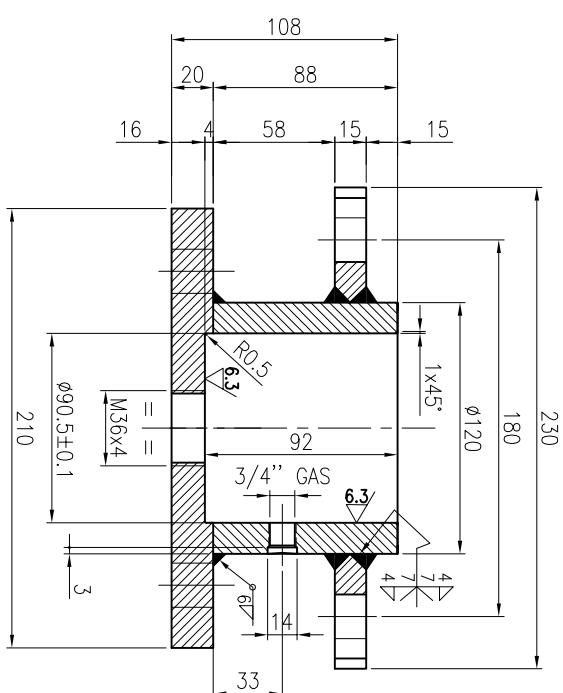

9.5 kg.

S355J0 or equivalent

[illegible]

Formato: A2	
-------------	--