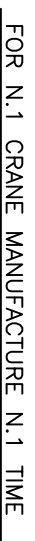
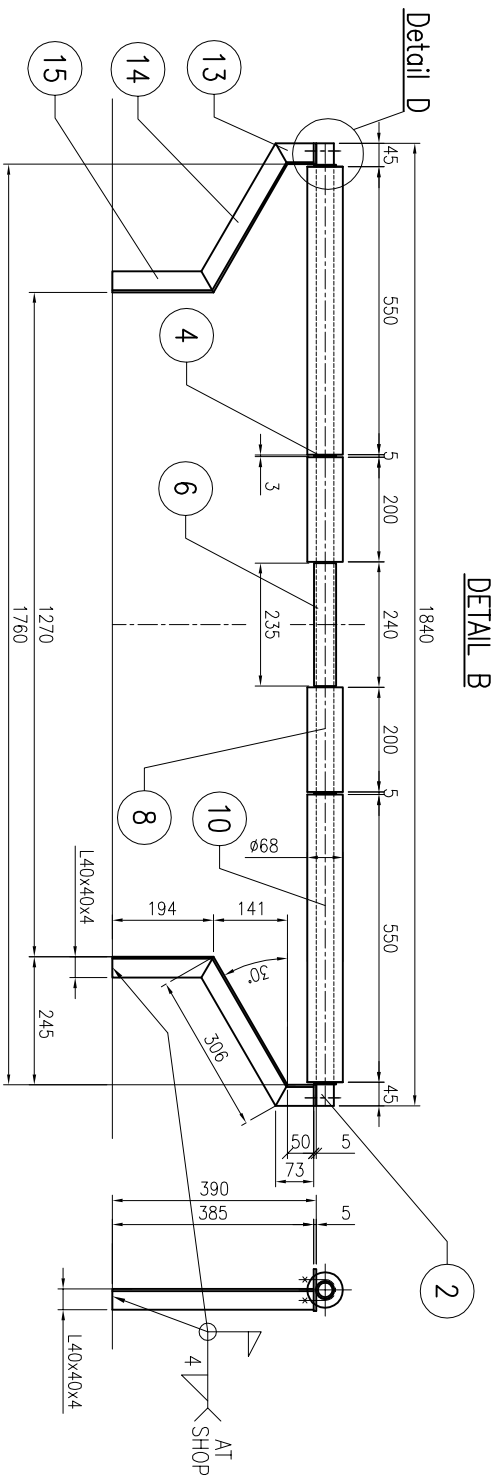
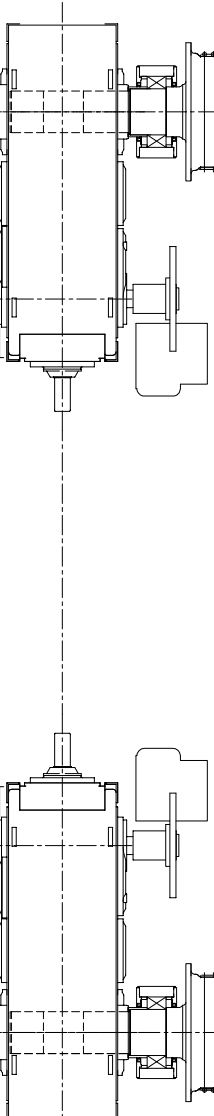
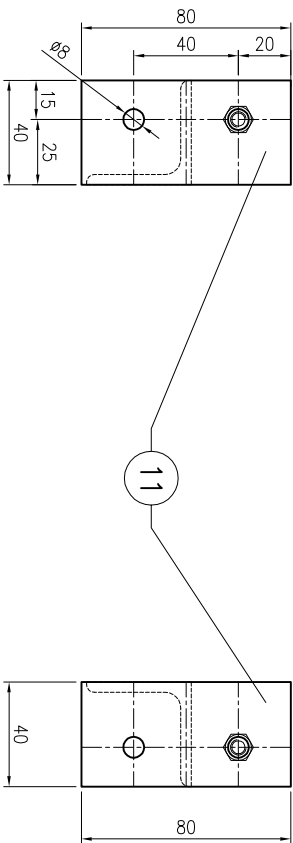


(TYPICAL)  
Scale 1:2

(TYPICAL)  
Scale 1:2

[illegible]