
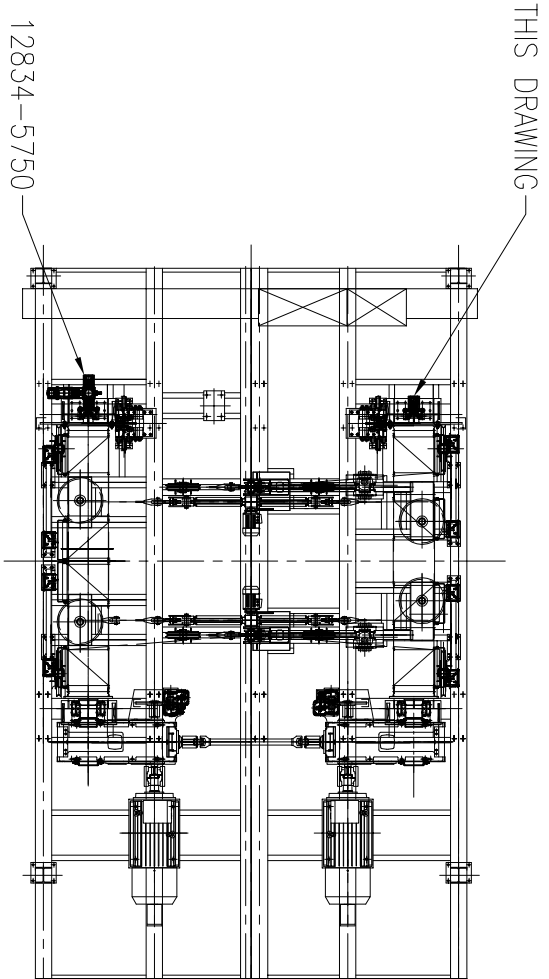


KEY PLAN

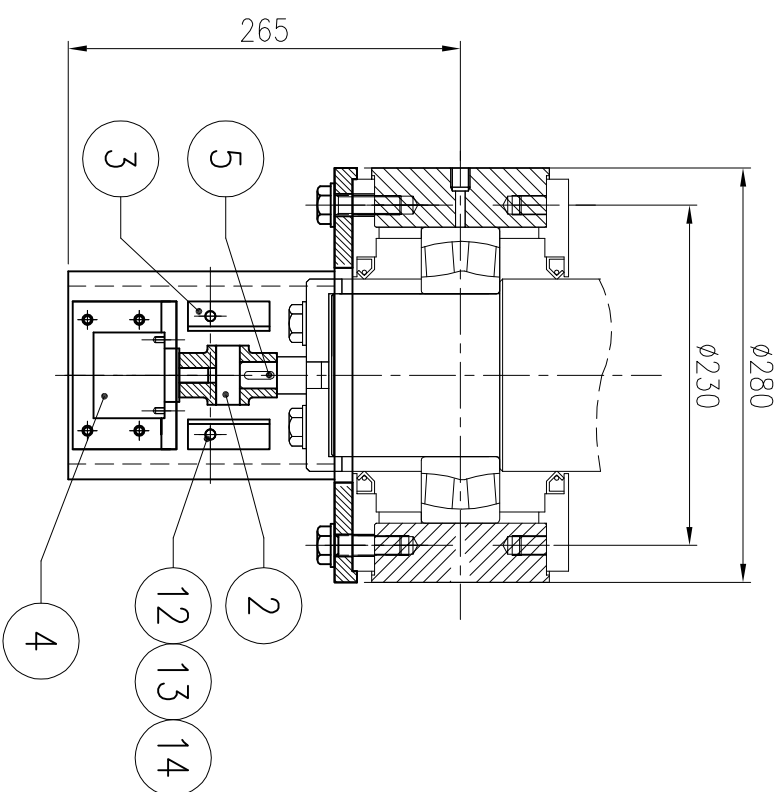

FOR N.1 CRANE MANUFACTURE N.1 PIECE

[illegible]

<u>MG</u>		ROKAS		Customer: PIRAEUS PORT AUTHORITY		DIS- DRAWER		<i>GM</i>	
<u>OMG</u>									
CONSTRUCTIONS S.A.		Object: N.8 RMG 40t		VER.		DB		DATA DATE	
TEL. +30-2108774100 FAX +30-2108774121 or 111		Project: F0010		APP.		RM		18/02/09	
WWW.ROKASGROUP.GR		Dis. di riferimento N. Ref. Drawing		12834-5500		Pos.		22	
HOISTING CONTROLS ASSEMBLY		Comm. / Job		Disegno / Drawing		1 / 1			
N.		18033		N.		12834-5751			

Formato: A3