


(\*) Material : S355J0 or Equivalent

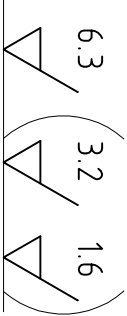

FOR N.1 CRANE MANUFACTURE N.2 PIECES

00	20/02/09	FIRST ISSUE					GF	RM	
	DATA DATE	MODIFICA ESEGUITA O MOTIVO DELLA SOSTITUZ. MODIFICATION EXECUTED OR REASON OF THE REPLACEMENT					DIS. DRAWER	APP.	
	Fabb. di riferimento N. Ref. material list 12834-5500	Materiale Material (*)	Troattamento Treatment	Toll. gen. lav. Mach tolerance H11-d11	Mod. o stampo Type	Peso Weight Kg 1,5	Scala Scale 1:2		

<div><div><div>MM</div><div>OMG</div></div><div><div>CONSTRUCTIONS S.A.</div><div>TEL. +30-2108774100</div><div>FAX +30-2108774121 or 111</div></div><div><div>WWW.ROKASGRUP.IGR</div><div>Customer: PIRAEUS PORT AUTHORITY</div><div>Object: N.8 RMG 40t</div><div>Project: F0010</div></div></div>		DIS. DRAWER		DATA DATE	
		VER.		DB	
		APP.		RM	
				20/02/09	
		Dis. di riferimento N. Ref. Drawing		Pos. 5	
		12834-5500		00	
SPACER		Comm. /Job		Disegno / Drawing	
		N. 18033		1/1	
		N. 12834-5513			