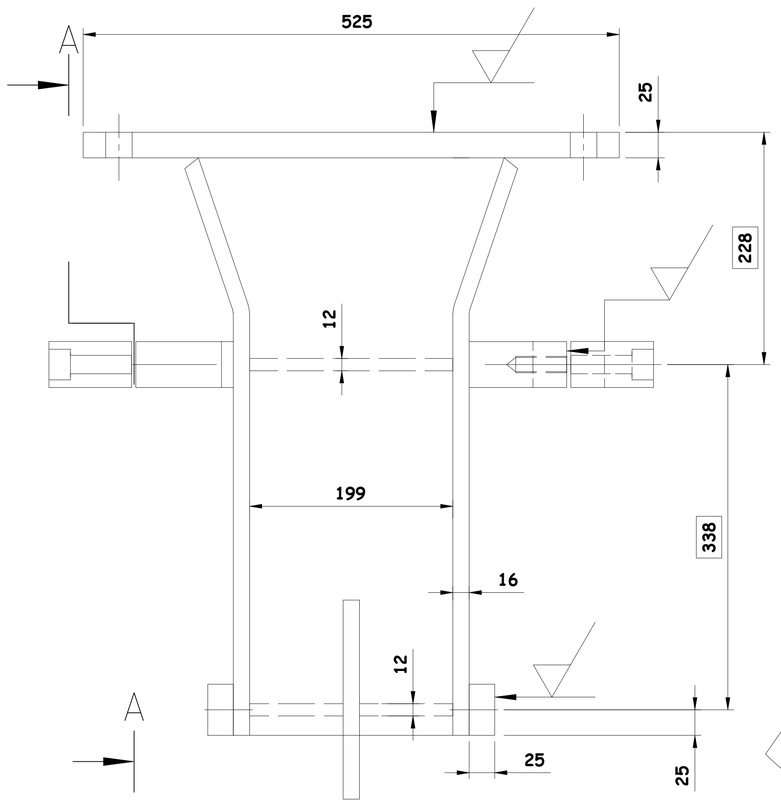

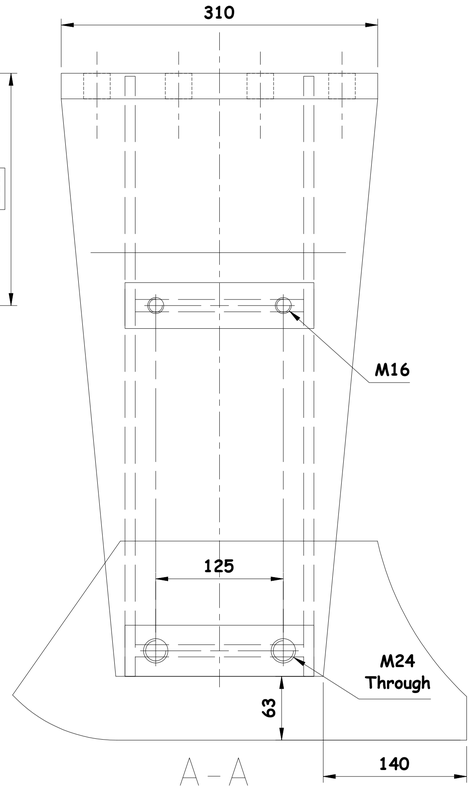

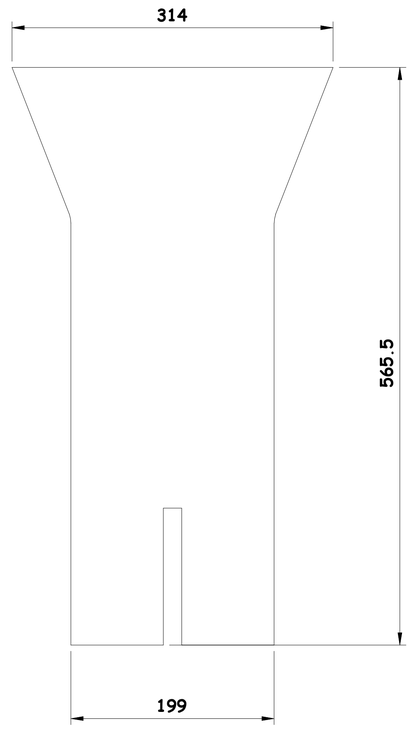

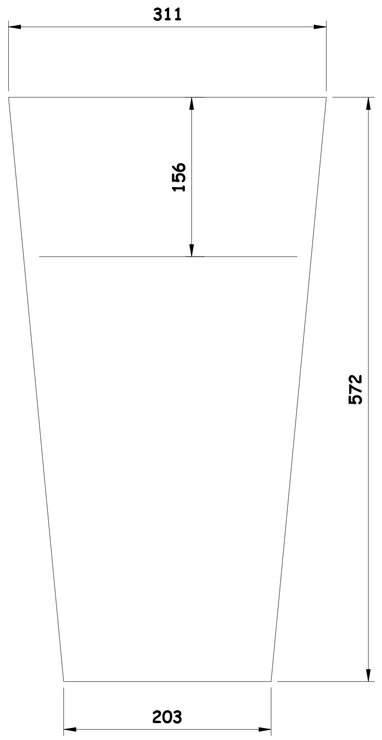

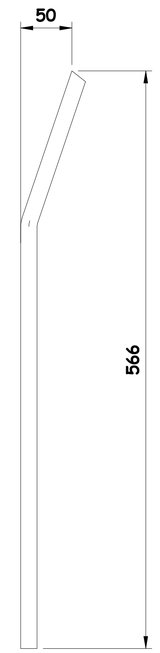

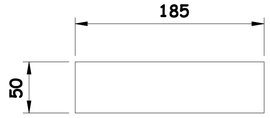

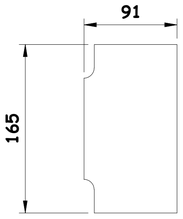

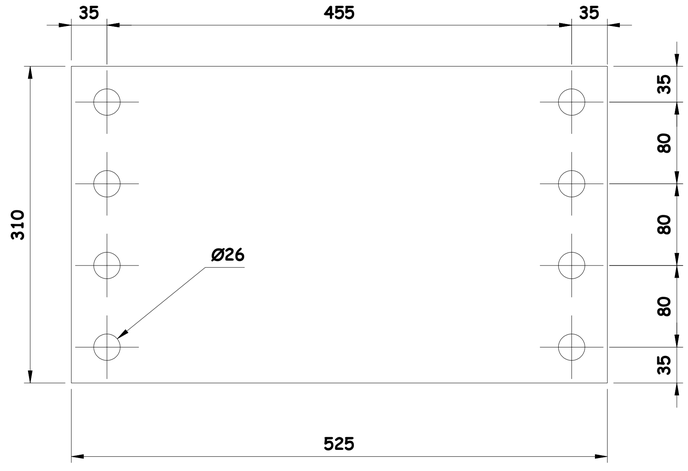

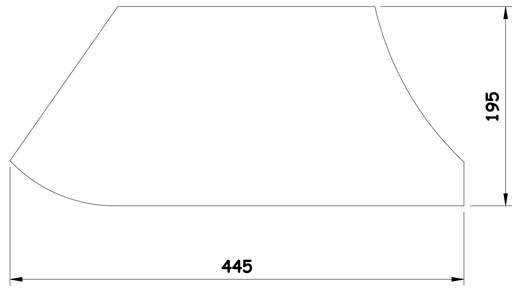

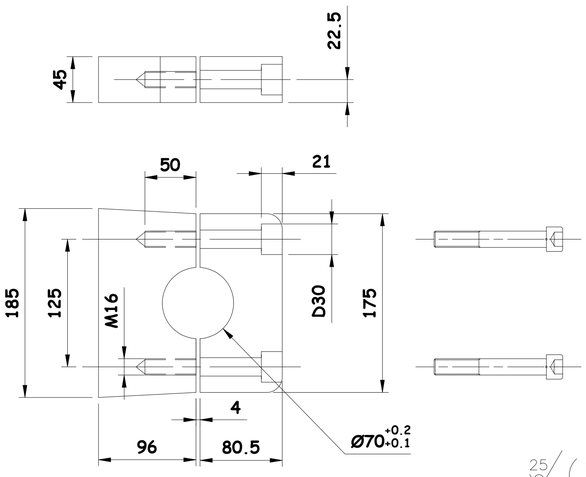

25 (6.3 1.6)

NOTES:

1. EXCEPT WHERE OTHERWISE INDICATED WELDS MUST BE A=0.7xMIN. THK, WHERE IS NOT POSSIBLE
2. WELD SYMBOLS IN ACCORDANCE TO AWS STANDARD
3. EDGE PLATES ROUNDED OFF AVOID THE DETACHEMENT OF PAINT

INDEX	DATE	NAME	DESCRIPTION
00	23/03/2010	JohnnieK	FIRST ISSUE

CUSTOMER: PIRAEUS PORT AUTHORITY

PROJECT: N.8 RMG - 40 t. SPAN 42.5m

OBJECT: ROLLER GUIDE SUPPORT

	DATE	NAME	SIGNATURE	SCALE
DRAWN BY	03/2010	JohnnieK		1:3
CHECKED BY				
APPROVED				
MATERIAL	S355J0			
WEIGHT	110			SHEET 1
SAP CODE		SIZE A1		FROM 1

ROKAS CONSTRUCTIONS S.A.
3, RIZARIOU str.-15233 ATHENS-GREECE
TEL: +30-2108774100 , FAX: +30-2108774121 or 111

PROJECT No	GROUP No	DRAWING No	REV.
F010	5000	M0501	00

REPLACES | REPLACED BY